


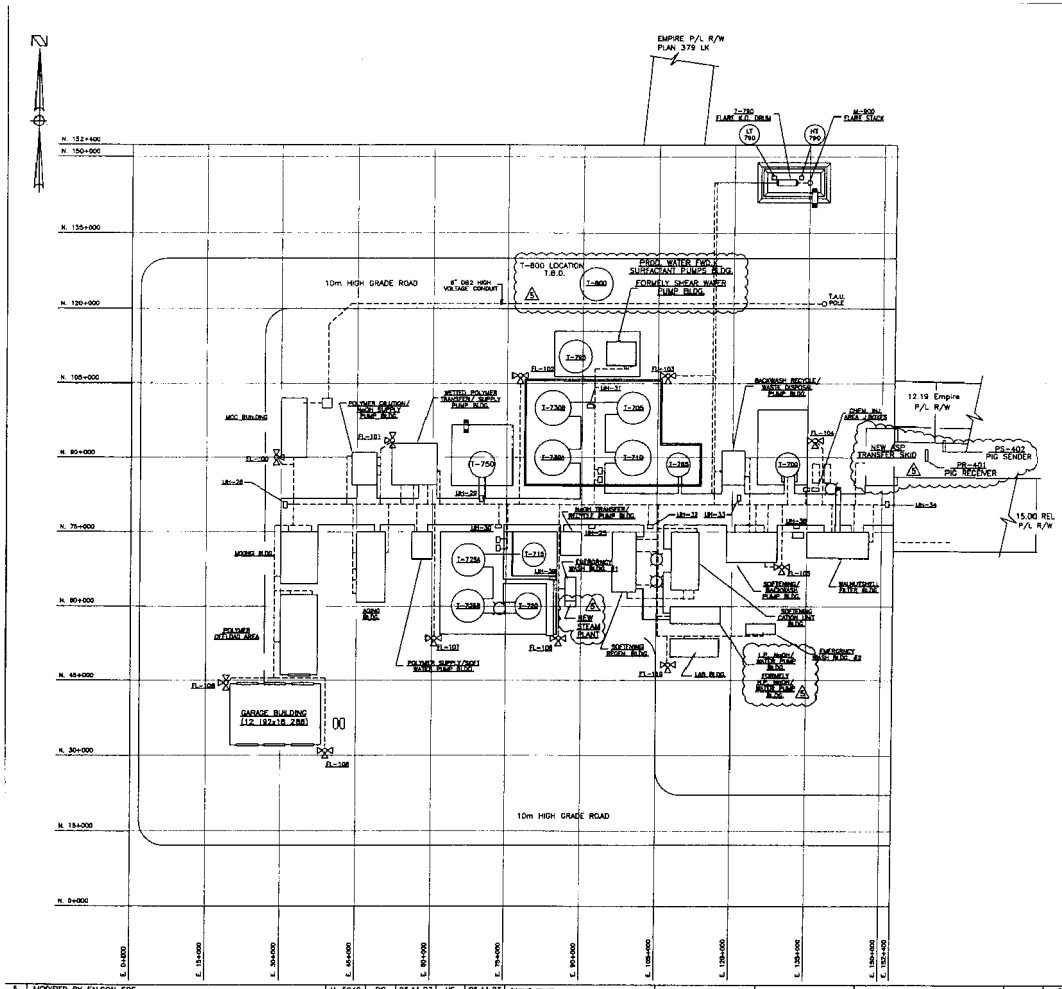


LOCATION PLAN
SCALE = 1:5000

NOTES:

1. ALL TRENCHES SHALL BE RUN AS SHOWN WITH 90 DEGREE CORNERS.
2. ALL CABLES SHALL BE INSTALLED IN ACCORDANCE WITH THE SPECIFICATION(S) INCLUDED THE BID DOCUMENT.
3. DITCH ROUTING SHOWN IS TO BE USED AS A GUIDELINE ONLY. SHOULD ACTUAL MEASUREMENTS OF INSTALLED TRENCH VARY CONTRACTOR SHALL NOTE SUCH ON THE "AS-BUILT DWGS. CONTRACTOR SHOULD ALSO ALLOW FOR SUCH VARIANCES IN HIS BID.
4. SEE CABLE/CONDUIT SCHEDULE FOR DESCRIPTIONS.
5. "AS BUILT" DRAWINGS ARE GENERATED FROM CONSTRUCTION CHANGE INFORMATION FORWARDED TO BOWER DAMBERGER ROLSETH LTD. BY RENAISSANCE ENERGY LTD.'S FIELD SUPERVISOR'S AND HIRED CONTRACTORS. ANY CHANGES NOT DOCUMENTED WILL NOT APPEAR ON THE DRAWINGS AND THEREFORE THE DRAWING MAY NOT BE AN ACCURATE REPRESENTATION OF THE CONSTRUCTED FACILITY. THESE FACILITIES HAVE BEEN TRANSFERRED TO HUSKY OIL OPERATIONS LTD. (H.O.O.L.)
6. PRIOR TO THE COMMENCEMENT OF ANY CONSTRUCTION AND OR EXCAVATION IT SHALL BE THE RESPONSIBILITY OF A H.O.O.L. REPRESENTATIVE TO VERIFY THE LOCATION AND STATUS OF ANY PIPING, ELECTRICAL EQUIPMENT OR BUILDING.
7. ANY EXISTING EQUIPMENT PIPING, OR ELECTRICAL ON A FACILITY MODIFIED OR ADDED TO BY B.D.R. ENG. LTD. IS ONLY SHOWN AS A REPRESENTATION OF WHAT EXISTS AND MUST BE VERIFIED BY H.O.O.L.
8. ALL FLOODLIGHTS ARE SUPPLIED BY OWNER AND INSTALLED BY FIELD ELECTRICAL CONTRACTOR.

NOTE: ORIGINAL DRAWING BY BDR.
MODIFIED BY FALCON EDF.

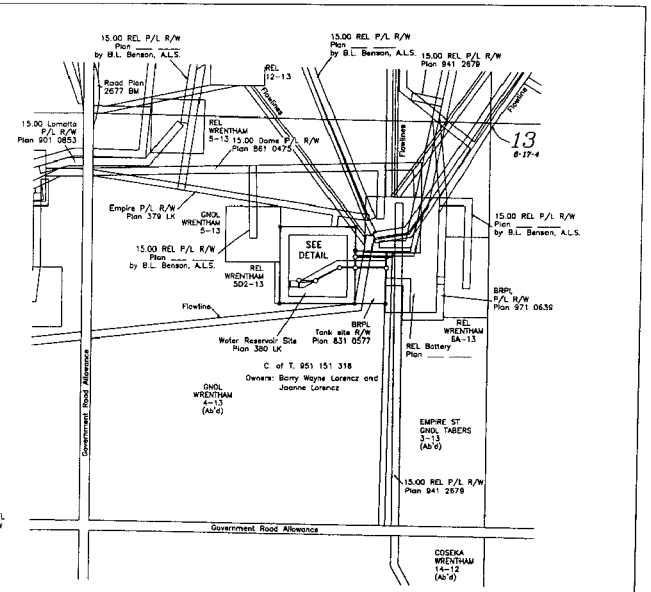FALCON EDF LIMITED

| NO. | REVISION | PROJ. No. | BY | DATE | CHK. | DATE |
|---|---|---|---|---|---|---|
| 5 | MODIFIED BY FALCON EDF | H-5040 | DS | 05.11.23 | HS | 05.11.23 |
| 4 | POST CONSTRUCTION REVISIONS | 23209 | PC | 03.02.07 | MSB | 03.02.07 |
| 3 | SHEARING WATER SYSTEM ADDITION | 23209 | FC | 02.11.15 | MSB | 02.11.22 |
| 2 | CLIENT'S NAME CHANGE | - | FC | 01.10.28 | MSB | 01.10.28 |
| 1 | AS-BUILT | 92200 | FC | 01.01.04 | BOO | 01.01.04 |
| 0 | AS-BUILT | 92200 | PC | 00.12.04 | MSB | 00.12.04 |
| C | ISSUED FOR CONSTRUCTION | 92200 | PC | 00.08.17 | MSB | 00.08.17 |
| B | ISSUED FOR BID | 92200 | PC | 00.08.17 | MSB | 00.08.17 |
| A | ISSUED FOR APPROVAL | 92200 | PC | 00.08.17 | MSB | 00.08.17 |

PERMIT STAMP:

GENERAL NOTES:

| | BY | DATE |
|---|---|---|
| DRN. | PC | 00.08.17 |
| CHK. | MSB | 00.08.17 |
| APP'D. | | |
| L.S.D. | 06-13-06-17 W4M | |

bdr
Bower Damberger Rolseth Engineering Ltd.

HUSKY OIL OPERATIONS LIMITED

ETZIKOM WATER FLOOD
PLOT PLAN

| SCALE | DRAWING NUMBER | REV |
|---|---|---|
| NTS | D-92200-F-01-01 | 5 |